

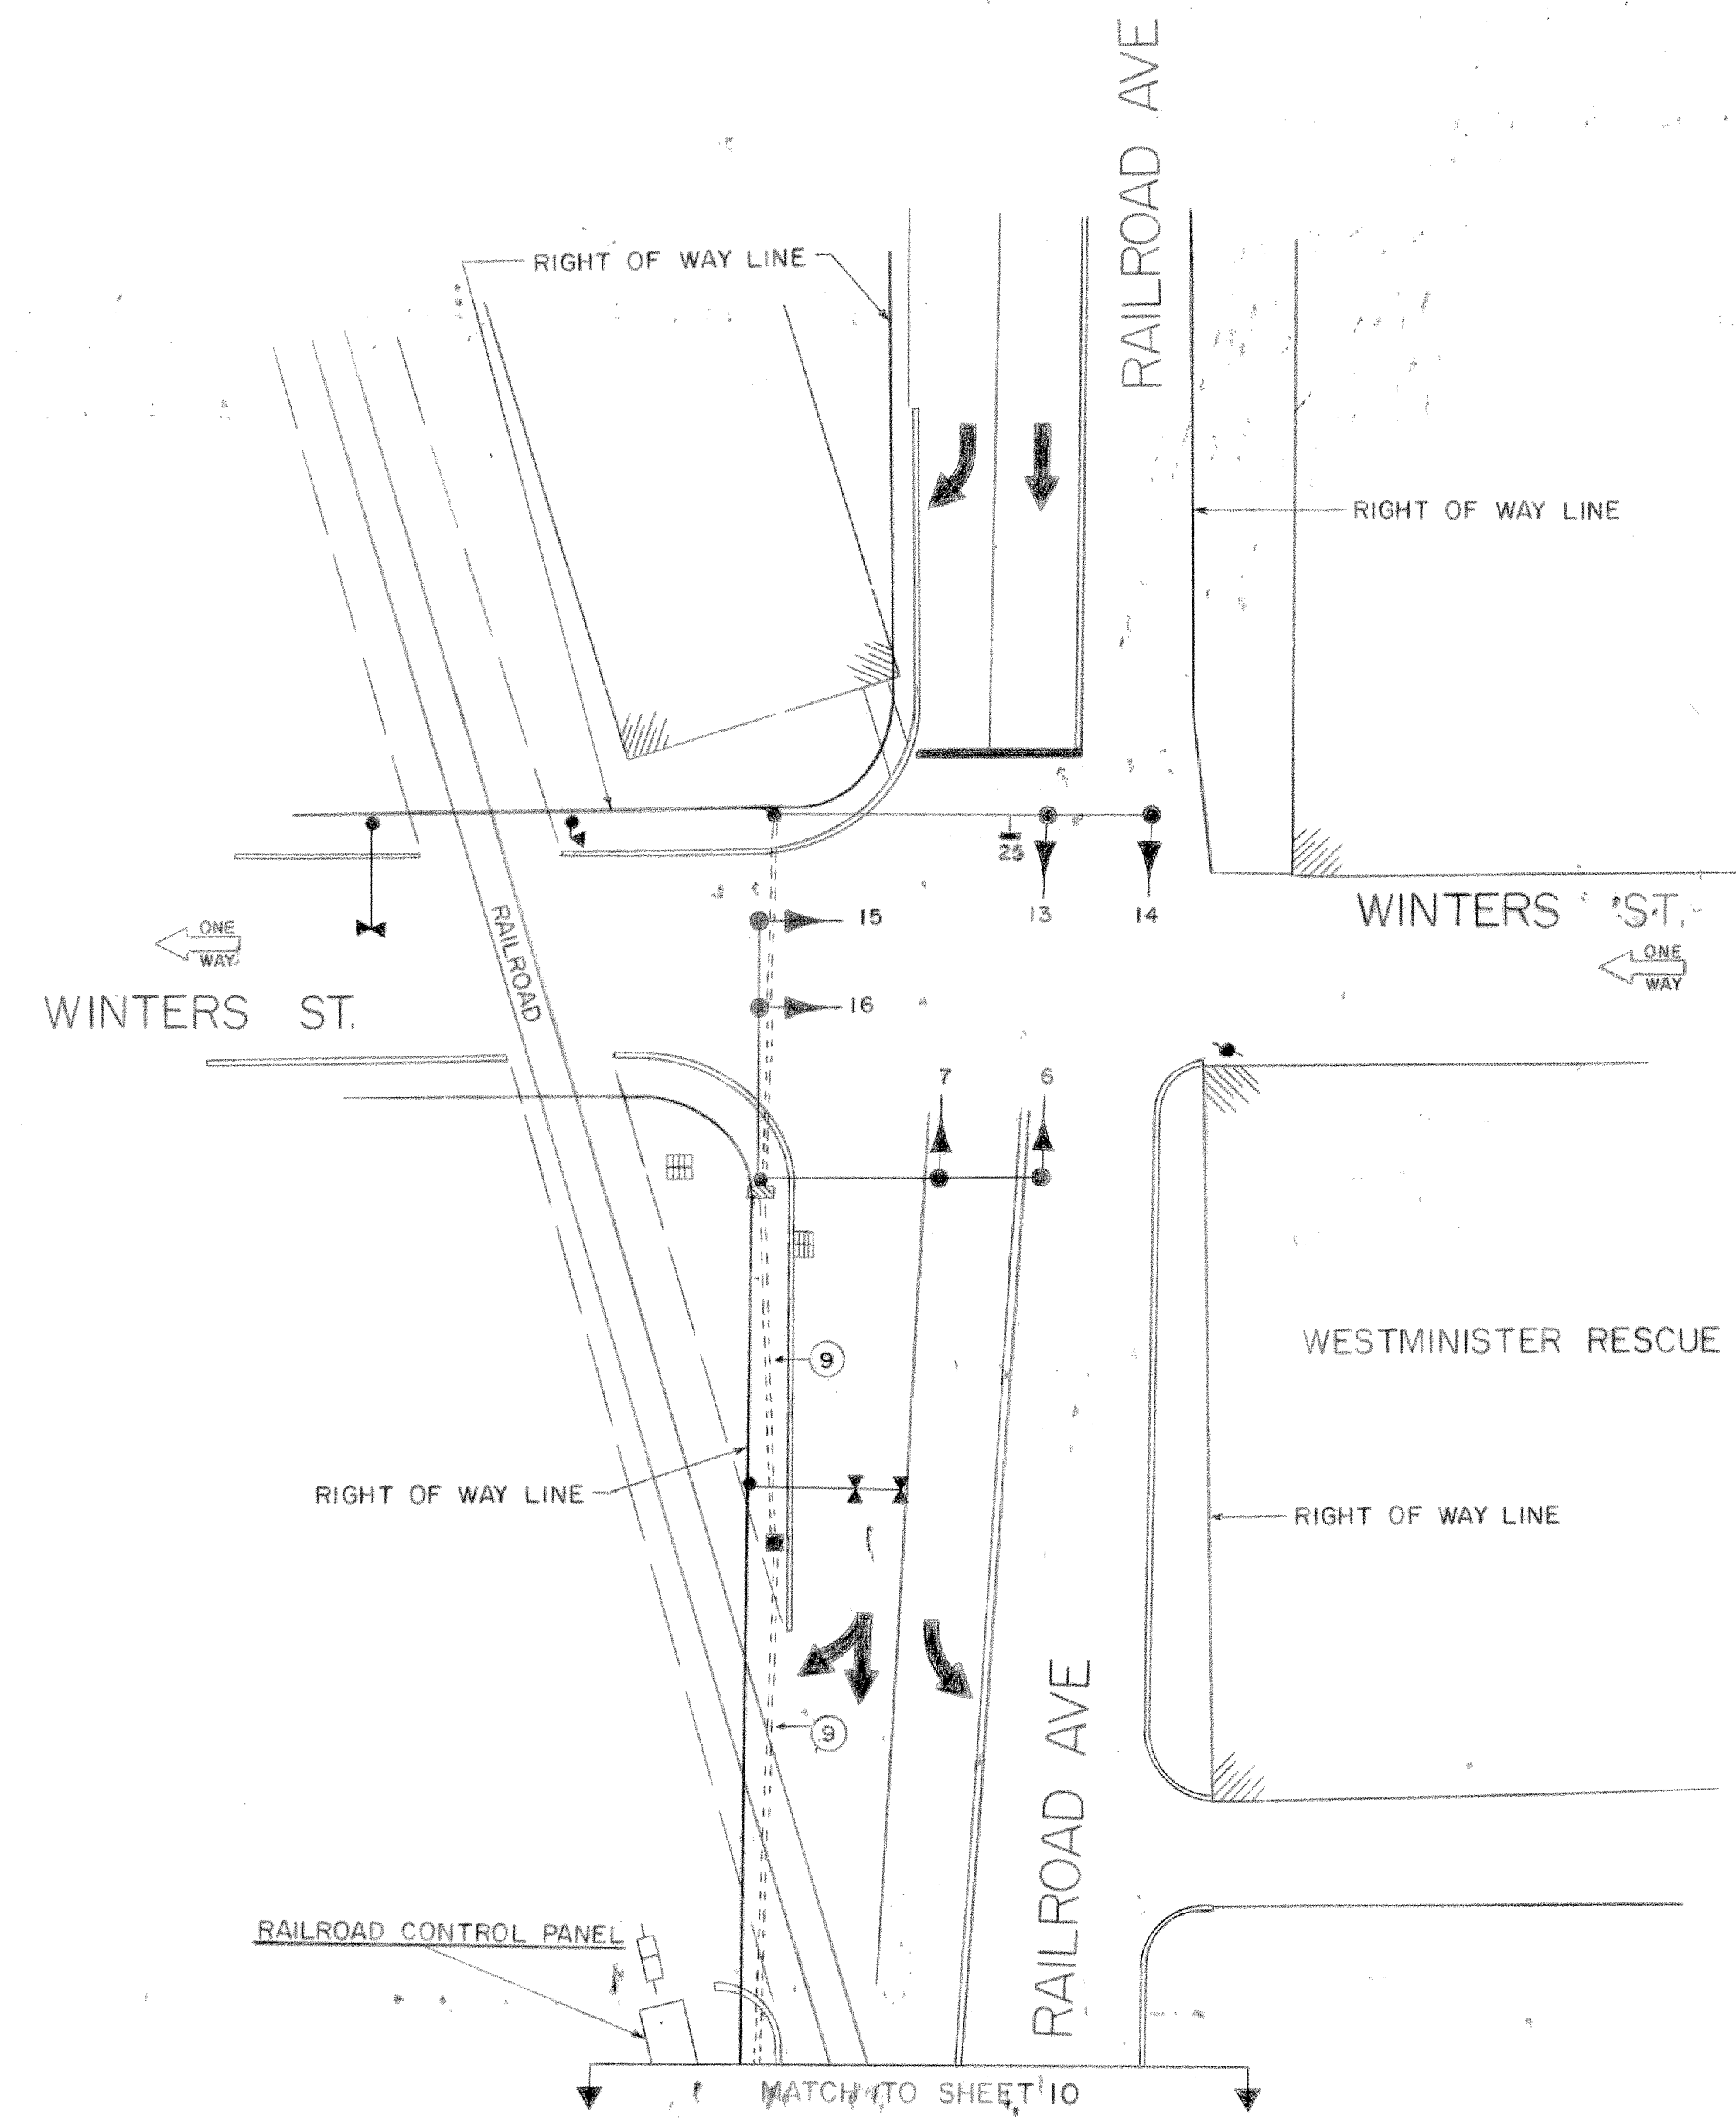


- NOTE:
- ① FOR S.H.A. RIGHT OF WAY SEE PLAT NO. 44098
 - ② EXISTING SIGNAL EQUIPMENT TO BE REMOVED BY B.T.O. (FUTURE)


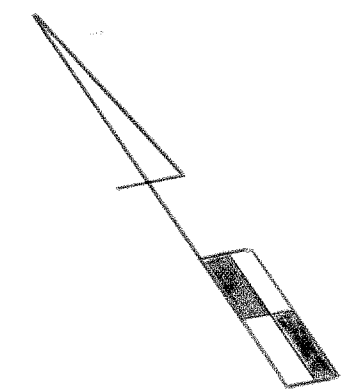


12" SIGNALS
6, 7, 13-16
R
Y
G

RAILROAD PRE-EMPTION

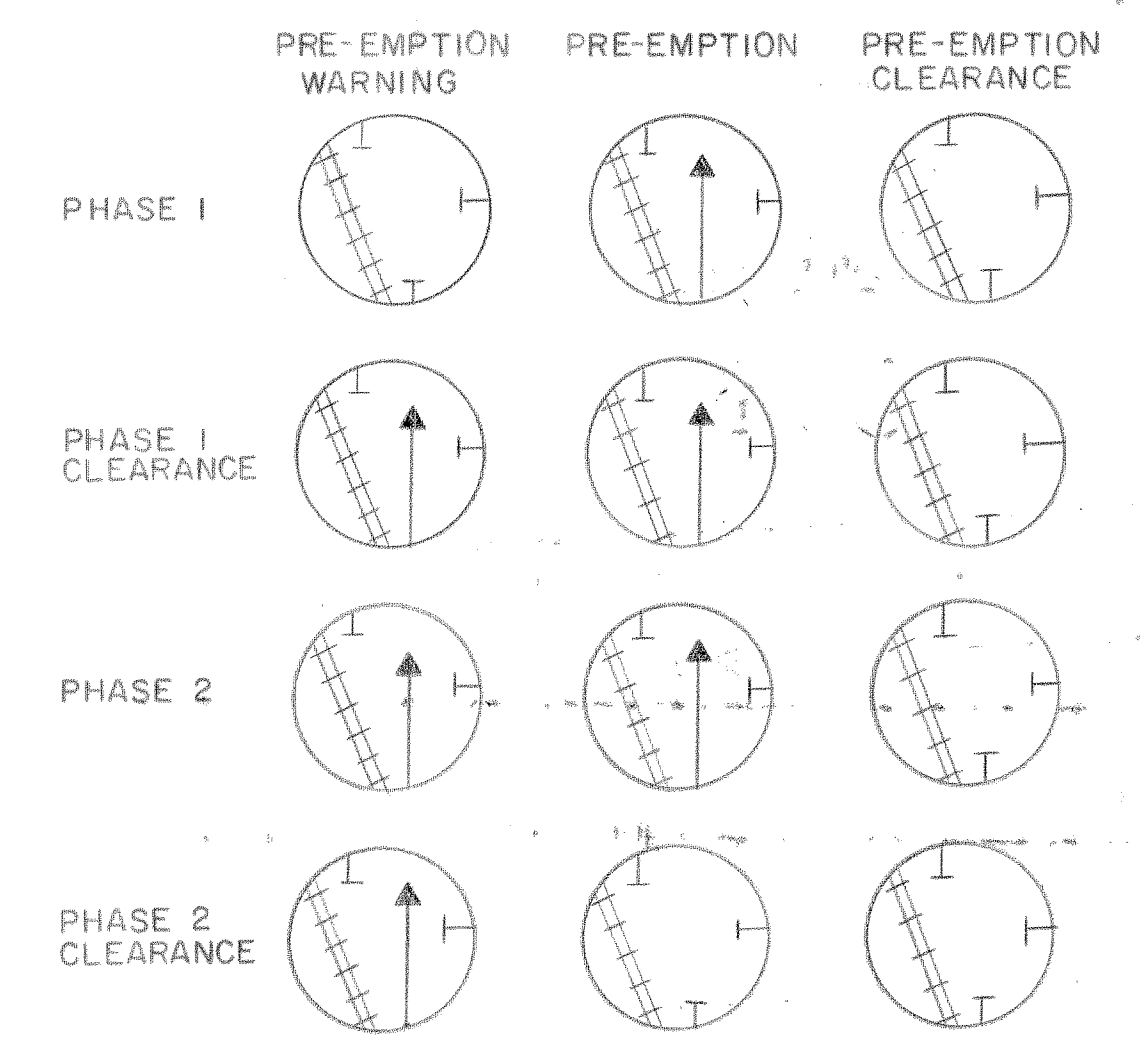

NORMAL OPERATION

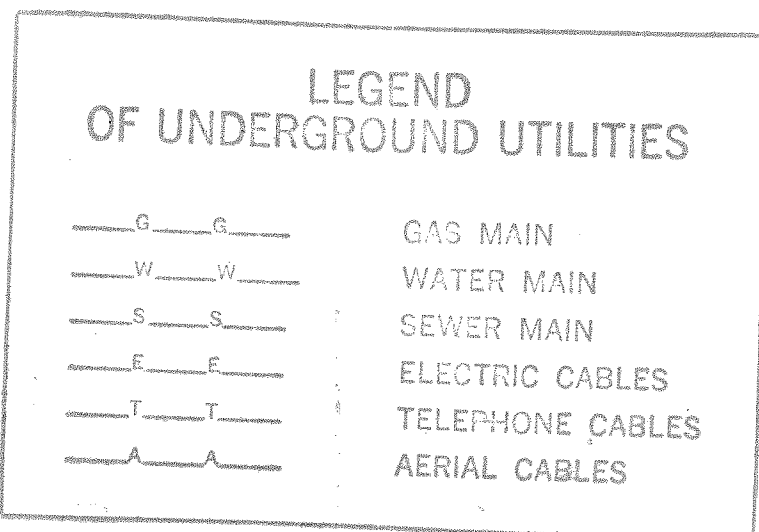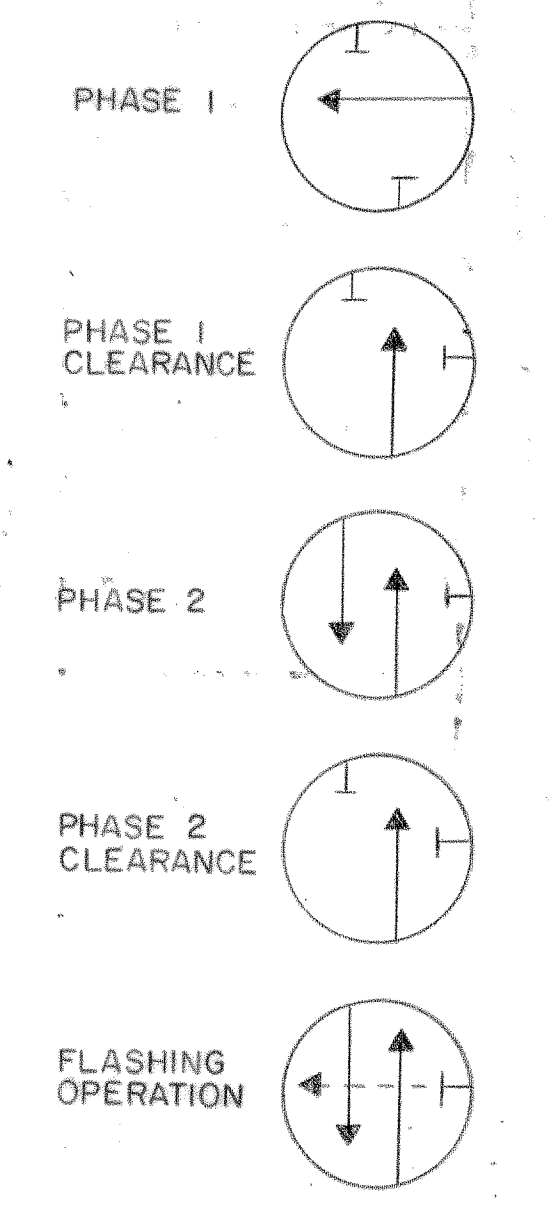

APPROVAL: REGIONAL TRAFFIC ENGINEER	
APPROVAL: CHIEF-BUREAU OF TRAFFIC ENGINEERING	B 12-14-81 ASBUILT
APPROVAL: ASST. CHIEF ENGINEER TRAFFIC	EMM A 5-12-76 ADD NEW INTERSECTION AND ADJUST STEEL POLES W/K
REVISIONS	
STATE OF MARYLAND DEPARTMENT OF TRANSPORTATION STATE HIGHWAY ADMINISTRATION TRAFFIC DIVISION - BUREAU OF TRAFFIC ENGINEERING RAILROAD AVE & WINTERS ST.	
SCALE 1" = 20'	DATE 5-4-76 CONTRACT NO. AW-629-503-785
DRAWN BY: H. KILIAN	COUNTY: CARROLL
DESIGNED BY:	SIGNAL NO:
CHECKED BY:	DRAWING NO. TS-1051B